

## Beaufort County Public Works Stormwater Infrastructure

**Project Summary** 

**Project Summary:** Southern Magnolia

**Activity:** Routine/Preventive Maintenance

Stellata Lane, Grandiflora Lane, Star Magnolia Court, Star Magnolia Drive and

**Duration:** 05/12/2021 - 08/17/2021

Shiney Leaf Court.

## **Narrative Description of Project:**

Project improved 9,552 L.F. of drainage system. Cleaned out 9,552 L.F. of roadside ditch. Jetted (12) crossline pipes and (105) driveway pipes. Hydroseeded for erosion control.

2021-547 / Southern Magnolia Subdivision	Labor		Labor	Equipment	Material	Contractor	Indirect	Total
	Hours		Cost	Cost	Cost	Cost	Labor	Cost
ASBUILT / Asbuilt - Project		12.00	\$359.82	\$17.40	\$22.14	\$0.00	\$79.24	\$478.60
AUDIT / Audit Project		6.50	\$202.61	\$0.00	\$0.00	\$0.00	\$125.06	\$327.67
CGRB / Channel - grubbed		56.00	\$1,139.68	\$254.69	\$112.85	\$0.00	\$528.64	\$2,035.86
CLPJT / Crossline Pipe - Jetted		83.00	\$2,155.60	\$1,432.55	\$328.75	\$0.00	\$1,222.96	\$5,139.86
DEBREM / Debris Removal - Jobsite		40.00	\$835.29	\$34.80	\$15.18	\$0.00	\$199.84	\$1,085.11
DPJT / Driveway Pipe - Jetted		341.00	\$8,577.33	\$5,180.59	\$1,252.81	\$0.00	\$4,578.56	\$19,589.30
GACA / Grubbed and Cleared		32.00	\$651.76	\$176.95	\$81.90	\$0.00	\$264.32	\$1,174.93
HAUL / Hauling		468.00	\$11,651.02	\$8,881.96	\$2,803.23	\$0.00	\$8,782.90	\$32,119.11
HYDR / Hydroseeding		52.00	\$1,257.82	\$284.02	\$1,657.86	\$0.00	\$268.36	\$3,468.06
RSDCL / Roadside Ditch - Cleanout		792.00	\$17,717.53	\$3,606.56	\$1,270.48	\$0.00	\$6,516.04	\$29,110.61
UTLOC / Utility locates		5.00	\$123.50	\$0.00	\$0.00	\$0.00	\$66.15	\$189.65
WLR / Water Line - Repair		4.00	\$89.90	\$8.70	\$13.74	\$0.00	\$0.00	\$112.34
Grand Total	1	,891.50	\$44,761.86	\$19,878.22	\$7,558.94	\$0.00	\$22,632.07	\$94,831.09

**Before** 




During



After



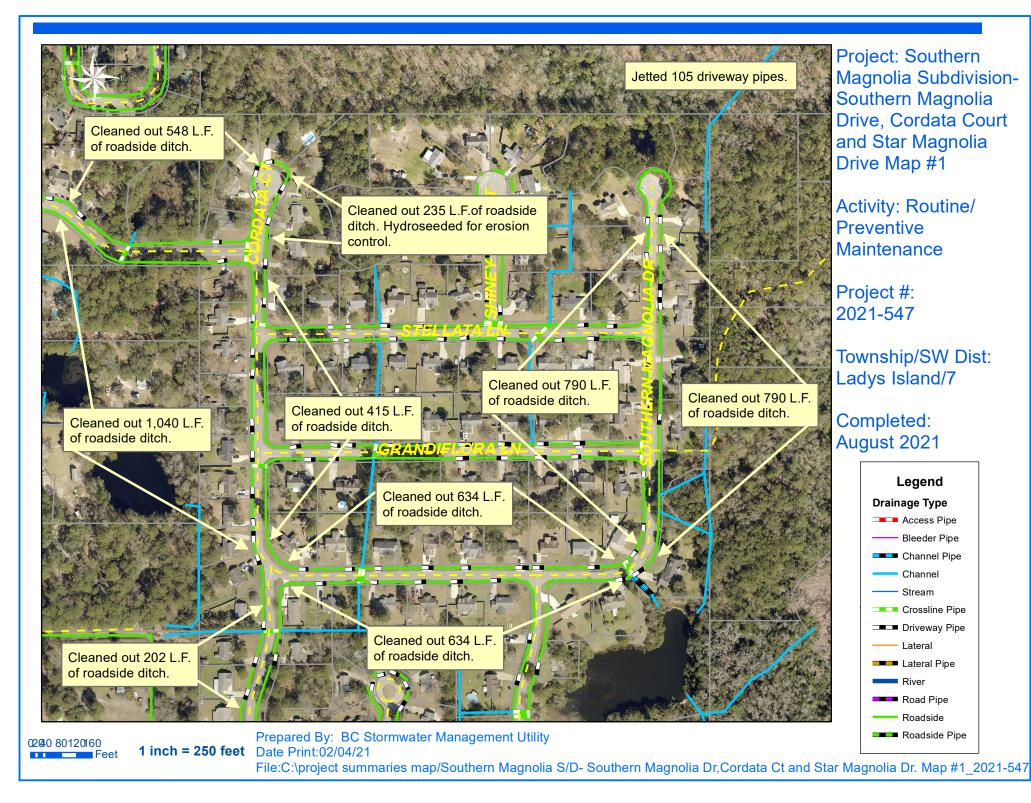




Project: Southern Magnolia Subdivison-Stellata Lane, Grandiflora Lane and Shiney Leaf Court Map #2

Activity: Routine/ Preventive Maintenance

Project #: 2020-547

Township/SW Dist: Ladys Island/7


Completed: August 2021

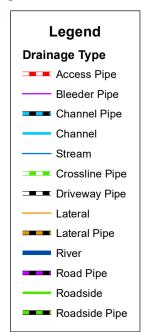

0 2550 100 150 200

1 inch = 170 feet

Prepared By: BC Stormwater Management Utility Date Print:03/30/21

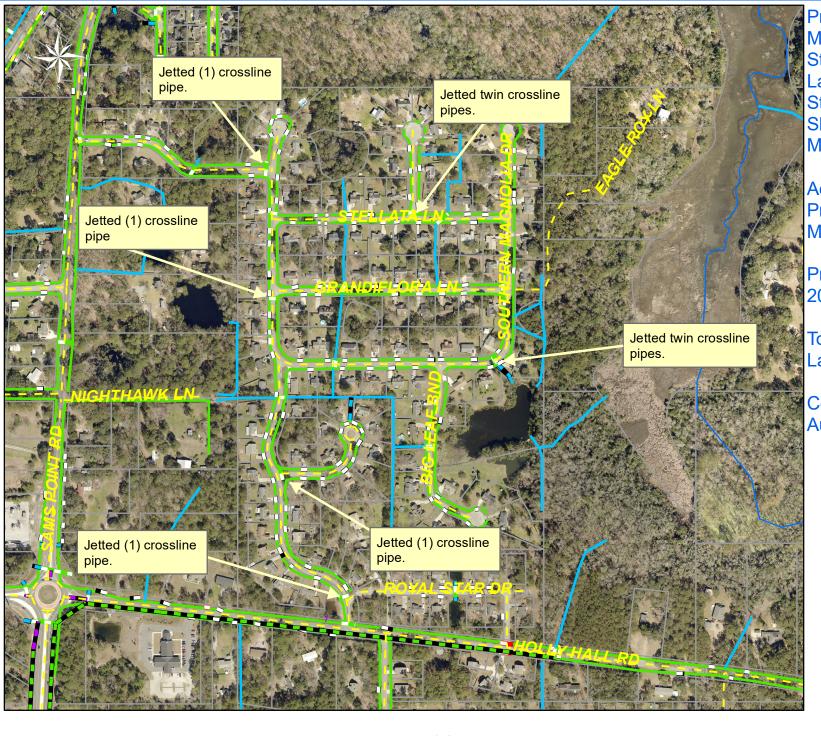


Project: Southern
Magnolia SubdivisonStellata Lane, Grandiflora
Lane, Star Magnolia Ct,
Star Magnolia Drive and
Shiney Leaf Court
Map #3

Activity: Routine/ Preventive Maintenance

Project #: 2020-547

Township/SW Dist: Ladys Island/7

Completed: August 2021

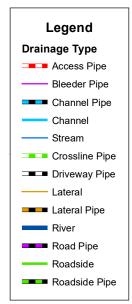

1 inch = 420 feet

0 65130 260 390 520

Prepared By: BC Stormwater Management Utility Date Print:02/04/21